SCALE: HOR. 1"= 40'
VERT. 1"= 8'

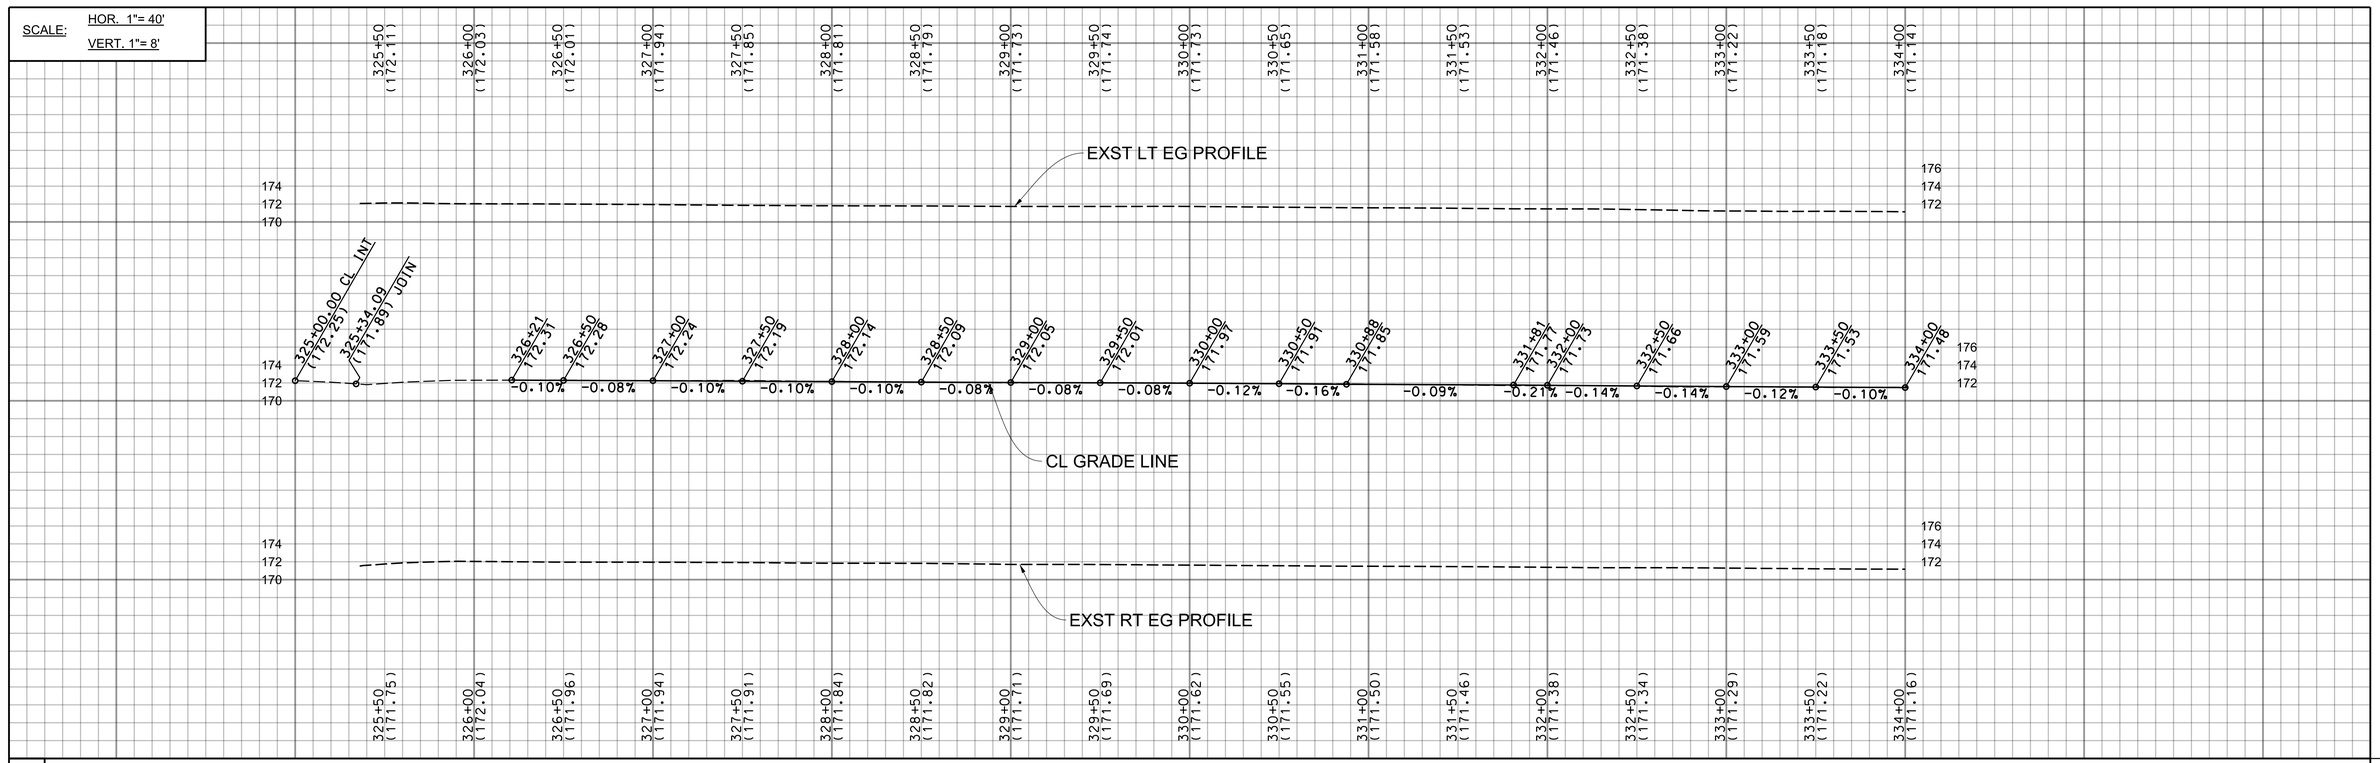

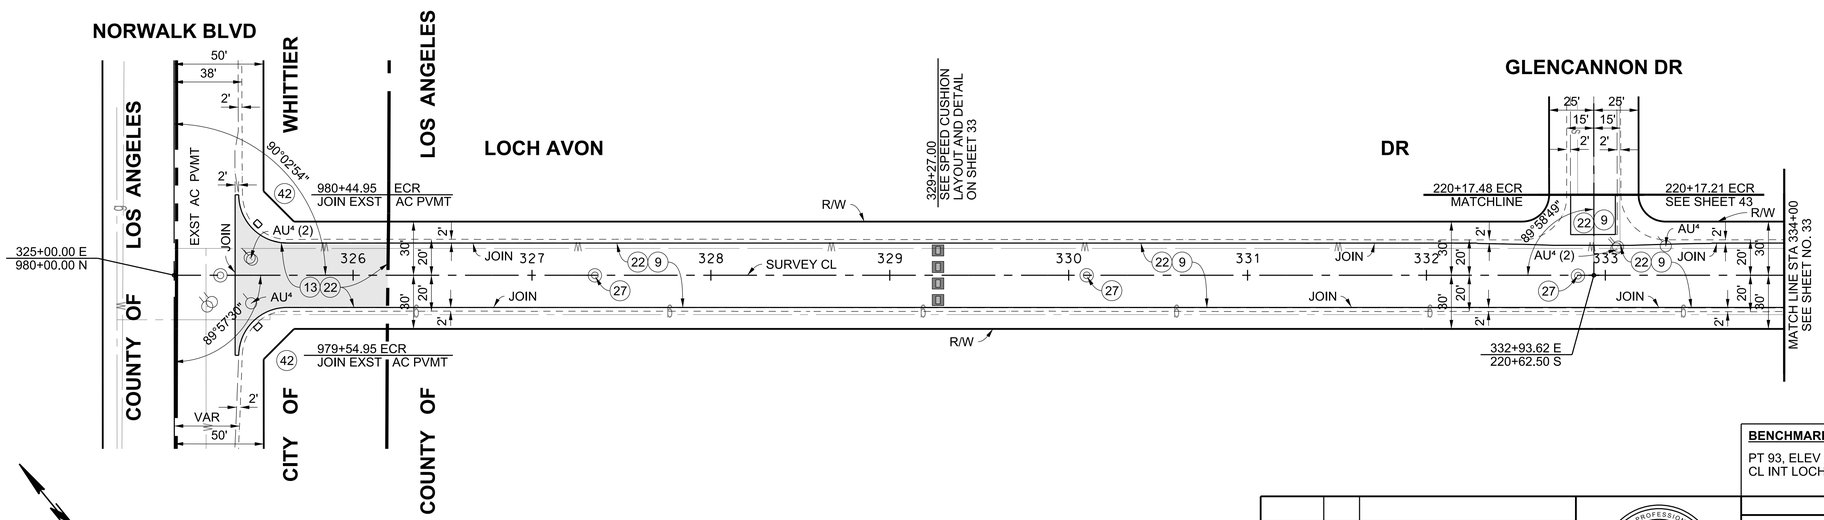

PLAN
SCALE: 1" = 40'
20 0 40 80

BENCHMARK

PT 93, ELEV 171.52 (WHITTIER & BASELINE QUAD 2005), PWFB 1026, PG 2121
CL INT LOCH AVON DR & GLENCANNON DR FD S&DPW W FL, PER R1

DATE	MARK	DESCRIPTION
10/25/2021	■	AS-BUILT

REVISIONS

REGISTERED PROFESSIONAL ENGINEER — BRIAN FUNG — C 76772 — CIVIL — STATE OF CALIFORNIA

PROJECT ENGINEER 6/24/19 DATE

LOS ANGELES COUNTY PUBLIC WORKS

SOUTH WHITTIER LOS NIETOS

KEITH DRIVE, ET AL.

PROJECT ID NO. RMD4408001
PLAN AND PROFILE

PD PH086551 | SHEET 32 OF 79

DRAFTER J. GARCIA
DESIGNER J. GARCIA
CHECKER B. FUNG
CADD PROJECT FILE NAME $FILE$

PLAN RD

DATE: $DATE$ TIME: $TIME$ FILE: $FILE$