SCALE: HOR. 1"= 40'
VERT. 1"= 8'

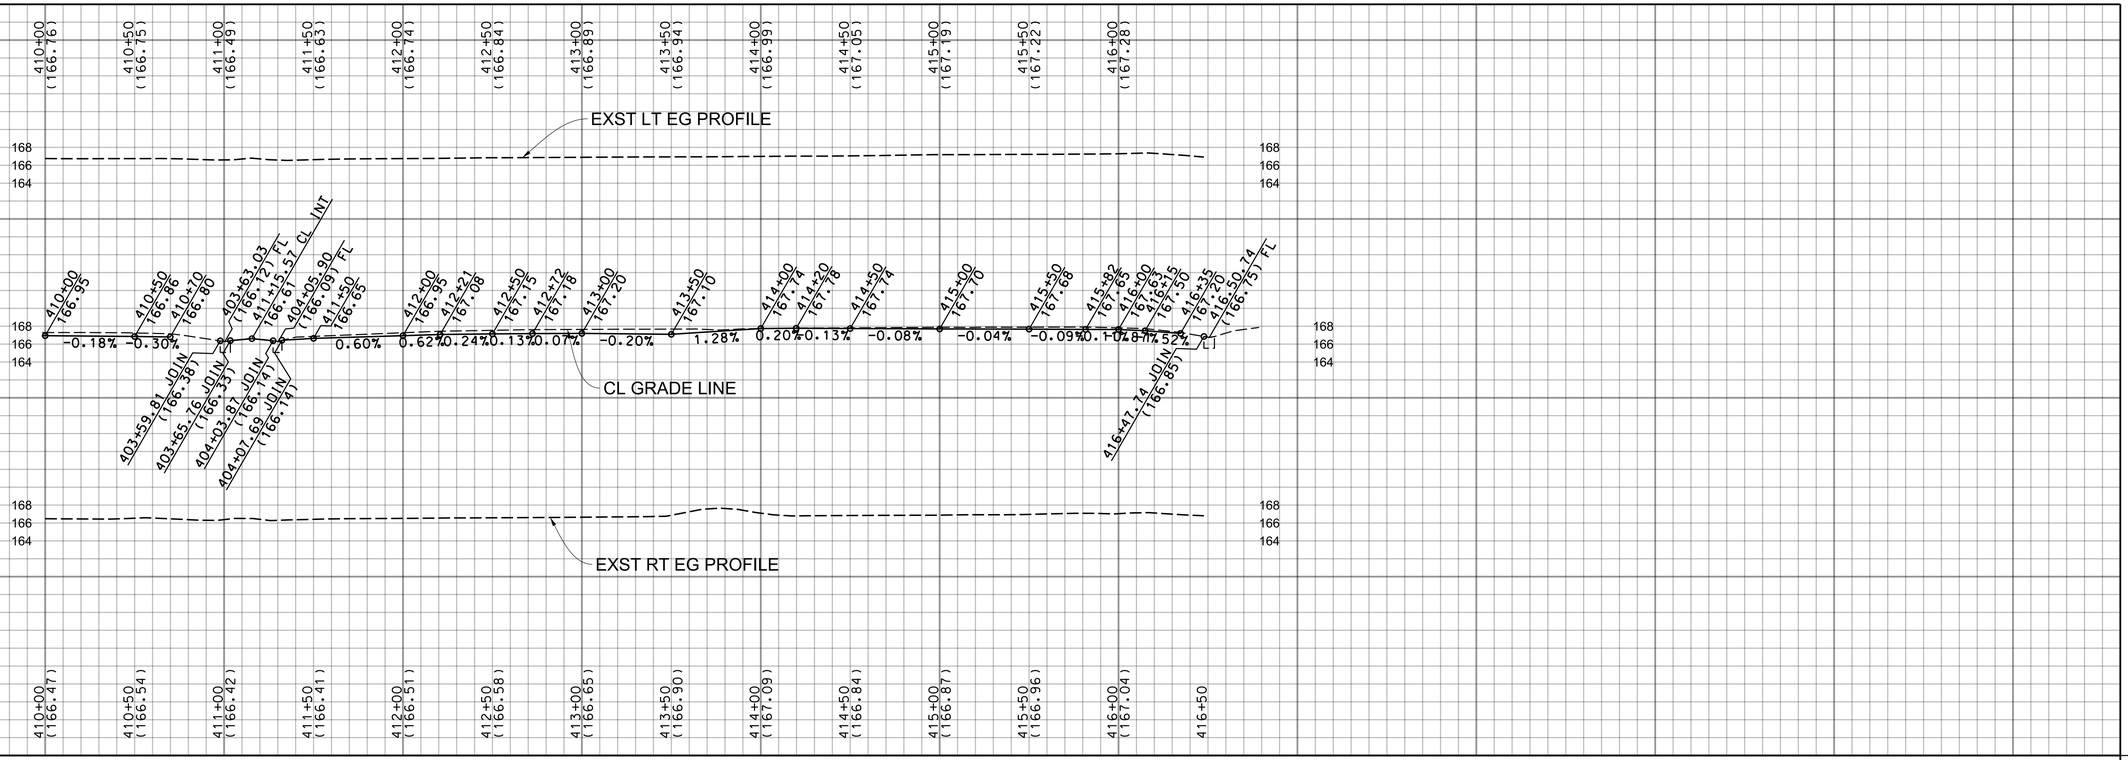

SEE SHEET 73 FOR PARKWAY IMPROVEMENTS

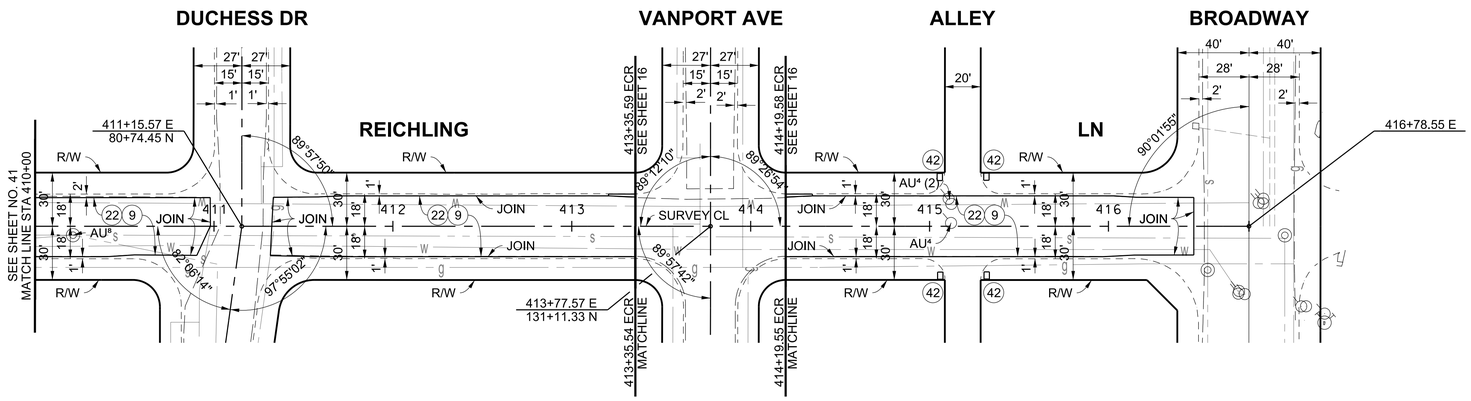

PLAN
SCALE: 1" = 40'
20 0 40 80

THE CONTRACTOR SHALL EXERCISE EXTREME CAUTION WHEN EXCAVATING FROM NORWALK BOULEVARD TO BROADWAY ON REICHLING LANE DUE TO THE SHALLOW SEWER. THE SEWER LINE IS APPROXIMATELY 3.5 FT TO 5 FT DEEP. THE CONTRACTOR SHALL LIMIT CONSTRUCTION EQUIPMENT LOADING DIRECTLY OVER THE SEWER DURING CONSTRUCTION.

BENCHMARK

PT 521, ELEV 167.68 (WHITTIER & BASELINE QUAD 2005), PWFB 1026, PG 2193
CL INT REICHLING LN & BROADWAY FD SPK & W PER R1, DN 3"

DATE	MARK	DESCRIPTION
10/25/2021	■	AS-BUILT

REVISIONS

REGISTERED PROFESSIONAL ENGINEER — BRIAN FUNG — C 76772 — CIVIL — STATE OF CALIFORNIA

PROJECT ENGINEER 6/24/19 DATE

LOS ANGELES COUNTY PUBLIC WORKS

SOUTH WHITTIER LOS NIETOS

KEITH DRIVE, ET AL.

PROJECT ID NO. RMD4408001

PLAN AND PROFILE

PD PH086560 | SHEET 41 OF 79

DRAFTER J. GARCIA | DESIGNER J. GARCIA | CHECKER B. FUNG | CADD PROJECT FILE NAME $FILE$

PLAN RD

DATE: $DATE$ TIME: $TIME$ FILE: $FILE$