

SHEET 5																
LOCATION	⑤			⑭			Case (see Sheet 76)	① A2-8			④①			②④	Utilities*	Remarks
	Width (LF)	Length (LF)	Area (SF)	Width (LF)	Length (LF)	Area (SF)		Length (LF)	6"-12" dia.	13"-24" dia.	25"+ dia.	Quantity				
11041 Aldrich St	-	-	-	20	9	180	3	-	-	-	-	-	-	-	-	AC driveway; On Glengarry Av
11102 Rose Hedge Dr	-	-	-	-	-	-	-	-	-	-	-	-	2	-	-	On Glengarry Av
11103 Rose Hedge Dr	-	-	-	-	-	-	-	22	-	2	-	-	1	-	-	On Glengarry Av
6902 Glengarry Av	-	-	-	-	-	-	-	40	-	1	-	-	-	-	-	-
Sheet total	0			180			62	3	3							

SHEET 6																
LOCATION	⑤			⑭			Case (see Sheet 76)	① A2-8			④①			②④	Utilities*	Remarks
	Width (LF)	Length (LF)	Area (SF)	Width (LF)	Length (LF)	Area (SF)		Length (LF)	6"-12" dia.	13"-24" dia.	25"+ dia.	Quantity				
11045 Townley Dr	-	-	-	-	-	-	-	55	-	3	-	-	-	-	-	on Glengarry Av
6704 Glengarry Av	4	34	136	-	-	-	-	-	-	-	-	-	-	-	-	-
6620 Glengarry Av	4	16	64	15	5	75	1	-	-	-	-	-	-	-	-	-
6614 Glengarry Av	4	18	72	-	-	-	-	-	-	-	-	-	-	-	-	-
6608 Glengarry Av	4	8	32	15	5	75	1	-	-	-	-	-	-	-	-	-
6602 Glengarry Av	-	-	-	13	5	65	1	-	-	-	-	-	-	-	-	-
Sheet total	304			215			55	0	3	0	0					

SHEET 7																
LOCATION	⑤			⑭			Case (see Sheet 76)	① A2-8			④①			②④	Utilities*	Remarks
	Width (LF)	Length (LF)	Area (SF)	Width (LF)	Length (LF)	Area (SF)		Length (LF)	6"-12" dia.	13"-24" dia.	25"+ dia.	Quantity				
11048 Loch Avon Dr	-	-	-	16	10	160	2	-	-	-	-	-	-	-	-	on Glengarry Av
6442 Glengarry Av	9	50	450	-	-	-	-	-	-	2	-	-	-	-	-	-
6414 Glengarry Av	-	-	-	16	5	80	3	-	-	-	-	-	-	-	-	-
11102 See Dr	4	65	260	20	5	100	1	-	-	1	-	-	-	-	-	on Glengarry Av
11103 See Dr	4	77	308	-	-	-	-	-	-	2	-	-	-	-	-	on Glengarry Av
6422 Glengarry Av	-	-	-	13	5	65	3	-	-	-	-	-	-	-	-	-
11102 Rincon Dr	-	-	-	20	5	100	1	-	-	-	-	-	-	-	-	on Glengarry Av
11102 Rincon Dr	-	-	-	14	5	70	1	-	-	-	-	-	-	-	-	on Glengarry Av
11103 Rincon Dr	-	-	-	20	5	100	1	-	-	-	-	-	-	-	-	on Glengarry Av
11103 Rincon Dr	-	-	-	13	5	65	1	-	-	-	-	-	-	-	-	on Glengarry Av
11104 Whittier Blvd	-	-	-	22	5	110	3	-	-	-	-	-	-	-	-	on Glengarry Av; commercial driveway
11104 Whittier Blvd	-	-	-	27	5	135	3	-	-	-	-	-	-	-	-	on Glengarry Av; commercial driveway
Sheet total	1018			740			0	0	5	0	0					

SHEET 8																
LOCATION	⑤			⑭			Case (see Sheet 76)	① A2-8			④①			②④	Utilities*	Remarks
	Width (LF)	Length (LF)	Area (SF)	Width (LF)	Length (LF)	Area (SF)		Length (LF)	6"-12" dia.	13"-24" dia.	25"+ dia.	Quantity				
7116 Boer Av	-	-	-	16	8	128	3	-	-	1	-	-	-	-	-	-
Sheet total	0			128			0	1	0	0						

SHEET 9																
LOCATION	⑤			⑭			Case (see Sheet 76)	① A2-8			④①			②④	Utilities*	Remarks
	Width (LF)	Length (LF)	Area (SF)	Width (LF)	Length (LF)	Area (SF)		Length (LF)	6"-12" dia.	13"-24" dia.	25"+ dia.	Quantity				
6837 Boer Av	4	40	160	40	8	320	1	-	-	-	-	-	-	-	-	-
6836 Boer Av	-	-	-	16	7	112	1	-	-	-	-	-	-	-	-	-
6828 Boer Av	-	-	-	16	7	112	1	-	-	-	-	-	-	-	-	-
6816 Boer Av	-	-	-	-	-	-	-	47	-	-	-	-	-	-	-	-
11133 Reichling Ln	-	-	-	22	7	154	1	-	-	-	-	-	-	-	-	on Boer Av
Sheet total	160			698			47	0	0	0	0					

SHEET 10																
LOCATION	⑤			⑭			Case (see Sheet 76)	① A2-8			④①			②④	Utilities*	Remarks
	Width (LF)	Length (LF)	Area (SF)	Width (LF)	Length (LF)	Area (SF)		Length (LF)	6"-12" dia.	13"-24" dia.	25"+ dia.	Quantity				
11135 Hadley St	4	15	60	16	7	112	3	20	-	-	-	-	-	-	-	on Boer Av
6744 Boer Av	-	-	-	16	7	112	3	-	-	-	-	-	-	-	-	-
6736 Boer Av	-	-	-	16	7	112	3	27	-	-	-	-	-	-	-	-
Sheet total	60			336			47	0	0	0	0					


SHEET 11																
LOCATION	⑤			⑭			Case (see Sheet 76)	① A2-8			④①			②④	Utilities*	Remarks
	Width (LF)	Length (LF)	Area (SF)	Width (LF)	Length (LF)	Area (SF)		Length (LF)	6"-12" dia.	13"-24" dia.	25"+ dia.	Quantity				
7112 Duchess Dr	-	-	-	-	-	-	-	18	-	-	-	-	-	-	-	-
7106 Duchess Dr	4	11	44	16	7	112	1	30	-	-	1	-	-	-	-	AC driveway
7102 Duchess Dr	4	11	44	16	7	112	1	-	-	-	-	-	-	-	-	AC driveway
7018 Duchess Dr	4	11	44	16	7	112	1	35	-	-	-	-	1	-	-	AC driveway
7015 Duchess Dr	-	-	-	-	-	-	-	30	-	-	-	-	1	-	-	-
7005 Duchess Dr	-	-	-	-	-	-	-	62	-	-	-	-	1	-	-	-
6915 Duchess Dr	-	-	-	-	-	-	-	40	-	-	-	-	1	-	-	-
Sheet total	132			336			215	0	0	1	4					

SHEET 12																
LOCATION	⑤			⑭			Case (see Sheet 76)	① A2-8			④①			②④	Utilities*	Remarks
	Width (LF)	Length (LF)	Area (SF)	Width (LF)	Length (LF)	Area (SF)		Length (LF)	6"-12" dia.	13"-24" dia.	25"+ dia.	Quantity				
6905 Duchess Dr	4	20	80	20	7	140	1	-	-	-	-	-	-	-	-	AC driveway
6871 Duchess Dr	4	8	32	16	7	112	1	-	-	-	-	-	-	-	-	AC driveway
6864 Duchess Dr	4	8	32	16	7	112	1	-	-	-	-	-	-	-	-	AC driveway
6859 Duchess Dr	4	8	32	16	7	112	1	-	-	-	-	-	-	-	-	AC driveway
6828 Duchess Dr	4	20	80	16	7	112	1	20	-	-	-	-	-	-	-	-
6721 Duchess Dr	4	14	56	15	7	105	1	-	-	-	-	-	-	-	-	AC driveway
Sheet total	312			693			20	0	0	0	0					

* UTILITIES TO BE ADJUSTED BY OWNER

CADD PROJECT FILE NAME: \$FILE\$\$
 CHECKER: B. FUNG
 DESIGNER: J. GARCIA
 DRAFTER: J. GARCIA

10/25/2021	AS-BUILT
DATE	MARK
REVISIONS	

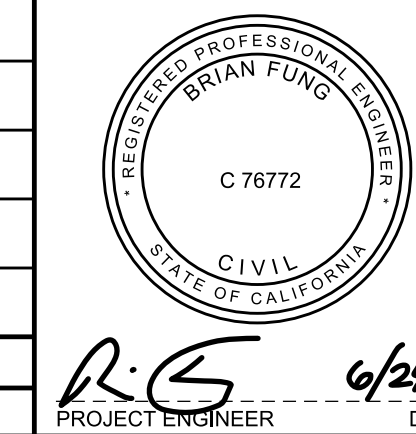

LOS ANGELES COUNTY PUBLIC WORKS

SOUTH WHITTIER LOS NIETOS

KEITH DRIVE, ET AL.

PROJECT ID NO. RMD4408001
PARKWAY IMPROVEMENTS TABLES

PD PH086587 SHEET 68 OF 79