

SHEET 20

LOCATION	⑤			⑭			Case (see Sheet 76)	① A2-8			⑳	Utilities*	Remarks
	Width (LF)	Length (LF)	Area (SF)	Width (LF)	Length (LF)	Area (SF)		Length (LF)	6"-12" dia.	13"-24" dia.			
7008 Gretna Av	-	-	-	-	-	-	-	50	-	-	1	-	-
6922 Gretna Av	4	16	64	16	5	80	1	-	-	-	-	-	AC driveway
6908 Gretna Av	-	-	-	16	5	80	1	-	-	-	-	-	-
6812 Gretna Av	4	32	128	-	-	-	-	-	-	-	-	-	-
6808 Gretna Av	4	30	120	-	-	-	-	-	-	-	-	-	-
6802 Gretna Av	-	-	-	14	5	70	1	-	-	-	-	1	-
6902 Gretna Av	-	-	-	11	5	55	1	-	-	-	-	-	-
6818 Gretna Av	-	-	-	20	5	100	1	-	-	-	-	-	-
6732 Gretna Av	-	-	-	15	5	75	1	-	-	-	-	-	-
6726 Gretna Av	-	-	-	12	5	60	1	-	-	-	-	-	-
6722 Gretna Av	-	-	-	13	5	65	1	-	-	-	-	-	-
11578 Rincon Dr	-	-	-	12	5	60	1	-	-	-	-	-	on Gretna Av
Sheet total			312			645		50	0	0	1	1	

SHEET 21

LOCATION	⑤			⑭			Case (see Sheet 76)	① A2-8			⑳	Utilities*	Remarks
	Width (LF)	Length (LF)	Area (SF)	Width (LF)	Length (LF)	Area (SF)		Length (LF)	6"-12" dia.	13"-24" dia.			
11579 Rincon Dr	5	10	50	-	-	-	-	-	-	-	-	-	on Gretna Av
6708 Gretna Av	4	16	64	12	5	60	1	-	-	-	1	water meter ⁴	-
6702 Gretna Av	4	50	200	12	5	60	1	-	-	-	1	water meter ⁴	-
6630 Gretna Av	4	52	208	12	5	60	1	-	-	-	1	-	-
6624 Gretna Av	4	10	40	12	5	60	1	-	-	-	-	-	-
6716 Gretna Av	-	-	-	12	5	60	1	-	-	-	-	-	-
6712 Gretna Av	-	-	-	14	5	70	1	-	-	-	-	-	-
11564 See Dr	-	-	-	20	5	100	1	-	-	-	-	-	on Gretna Av
11565 See Dr	-	-	-	12	5	60	1	-	-	-	-	-	on Gretna Av
6612 Gretna Av	-	-	-	20	5	100	1	-	-	-	-	-	-
6610 Gretna Av	-	-	-	22	5	110	1	-	-	-	-	-	-
Sheet total			562			740		0	0	0	2	1	

SHEET 22

LOCATION	⑤			⑭			Case (see Sheet 76)	① A2-8			⑳	Utilities*	Remarks
	Width (LF)	Length (LF)	Area (SF)	Width (LF)	Length (LF)	Area (SF)		Length (LF)	6"-12" dia.	13"-24" dia.			
Sheet total													

SHEET 23


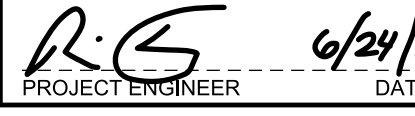
LOCATION	⑤			⑭			Case (see Sheet 76)	① A2-8			⑳	Utilities*	Remarks
	Width (LF)	Length (LF)	Area (SF)	Width (LF)	Length (LF)	Area (SF)		Length (LF)	6"-12" dia.	13"-24" dia.			
11103 See Dr	4	28	112	-	-	-	-	-	-	-	-	-	-
11108 See Dr	4	40	160	16	7	112	1	-	-	-	-	-	-
11111 See Dr	4	50	200	16	7	112	1	-	-	-	1	-	-
11114 See Dr	4	8	32	16	7	112	1	-	-	-	-	-	-
11117 See Dr	4	4	16	12	7	84	1	-	-	-	-	-	-
11121 See Dr	4	51	204	16	7	112	1	-	-	-	1	-	-
11126 See Dr	-	-	-	-	-	-	-	-	-	-	1	-	-
11127 See Dr	-	-	-	12	7	84	1	-	-	-	-	-	-
11141 See Dr	4	20	80	-	-	-	-	-	-	-	-	-	-
11147 See Dr	4	52	208	20	7	140	1	-	-	-	-	-	-
11148 See Dr	4	8	32	16	7	112	1	-	-	-	-	-	-
11202 See Dr	4	30	120	-	-	-	-	-	-	-	-	-	-
11209 See Dr	-	-	-	16	7	112	1	-	-	-	-	-	-
11213 See Dr	4	16	64	15	7	105	1	-	-	-	-	-	-
11214 See Dr	4	12	48	16	7	112	1	-	-	-	-	-	-
11220 See Dr	-	-	-	16	7	112	1	-	-	-	-	-	-
11224 See Dr	4	24	96	16	7	112	1	-	-	-	-	2	-
11230 See Dr	4	40	160	16	7	112	1	-	-	-	-	-	-
11234 See Dr	4	30	120	16	7	112	1	-	-	-	-	-	-
11238 See Dr	4	31	124	16	7	112	1	-	-	-	1	-	-
11241 See Dr	4	11	44	14	7	98	1	-	-	-	-	1	-
11237 See Dr	4	8	32	12	7	84	1	-	-	-	1	-	-
11120 See Dr	-	-	-	14	7	98	1	-	-	-	-	-	-
11131 See Dr	-	-	-	14	7	98	1	-	-	-	-	-	-
11138 See Dr	-	-	-	12	7	84	1	-	-	-	-	-	-
11137 See Dr	-	-	-	12	7	84	1	-	-	-	-	-	-
11144 See Dr	-	-	-	12	7	84	1	-	-	-	-	-	-
11153 See Dr	-	-	-	16	7	112	1	-	-	-	-	-	-
11159 See Dr	-	-	-	12	7	84	1	-	-	-	-	-	-
11203 See Dr	-	-	-	12	7	84	1	-	-	-	-	-	-
11210 See Dr	-	-	-	12	7	84	1	-	-	-	-	-	-
Sheet total			1852			2751		0	0	4	1	3	

SHEET 24

LOCATION	⑤			⑭			Case (see Sheet 76)	① A2-8			⑳	Utilities*	Remarks
	Width (LF)	Length (LF)	Area (SF)	Width (LF)	Length (LF)	Area (SF)		Length (LF)	6"-12" dia.	13"-24" dia.			
6322 Broadway	-	-	-	25	7	175	1	-	-	-	-	-	on See Dr
11404 See Dr	4	31	124	-	-	-	-	-	-	-	-	-	-
11416 See Dr	4	47	188	-	-	-	-	-	-	-	1	-	-
11417 See Dr	4	50	200	-	-	-	-	-	-	-	1	-	-
11420 See Dr	4	18	72	9	5	45	1	-	-	-	-	-	-
11421 See Dr	4	35	140	-	-	-	-	-	-	-	1	-	-
11426 See Dr	4	30	120	14	5	70	1	-	-	-	-	-	-
11427 See Dr	4	60	240	-	-	-	-	-	-	-	-	-	-
11430 See Dr	4	30	120	-	-	-	-	-	-	-	1	-	Private tree; minimal light root shaving
11431 See Dr	4	6	24	-	-	-	-	-	-	-	-	-	-
11436 See Dr	4	15	60	-	-	-	-	-	-	-	-	-	-
11437 See Dr	4	36	144	-	-	-	-	-	-	-	-	-	-
11440 See Dr	4	20	80	13	5	65	1	-	-	-	-	-	-
11441 See Dr	4	33	132	-	-	-	-	-	-	-	1	-	-
11446 See Dr	4	23	92	-	-	-	-	-	-	-	1	-	-
11447 See Dr	4	26	104	-	-	-	-	-	-	-	1	-	-
11452 See Dr	4	30	120	11	5	55	1	-	-	-	-	2	-
11453 See Dr	4	20	80	-	-	-	-	-	-	-	1	-	-
11462 See Dr	4	46	184	-	-	-	-	-	-	-	2	1	-
Sheet total			2224			410		0	0	4	5	6	

* UTILITIES TO BE ADJUSTED BY OWNER
⁴ SAN GABRIEL VALLEY WATER COMPANY

CADD PROJECT FILE NAME: \$FILE\$\$
 CHECKER: X. XXXXXXXX
 DESIGNER: X. XXXXXXXX
 DRAFTER: X. XXXXXXXX

10/25/2021		AS-BUILT		LOS ANGELES COUNTY PUBLIC WORKS SOUTH WHITTIER LOS NIETOS KEITH DRIVE, ET AL.	
DATE	MARK	DESCRIPTION		PROJECT ID NO. RMD4408001 PARKWAY IMPROVEMENTS TABLES	
REVISIONS			PROJECT ENGINEER: 	DATE: 6/24/19	PD PH086589 SHEET 70 OF 79