

SHEET 35

LOCATION	⑤			⑭			Case (see Sheet 76)	① A2-8			②④	Utilities*	Remarks
	Width (LF)	Length (LF)	Area (SF)	Width (LF)	Length (LF)	Area (SF)		Length (LF)	6"-12" dia.	13"-24" dia.			

SHEET 36

LOCATION	⑤			⑭			Case (see Sheet 76)	① A2-8			②④	Utilities*	Remarks
	Width (LF)	Length (LF)	Area (SF)	Width (LF)	Length (LF)	Area (SF)		Length (LF)	6"-12" dia.	13"-24" dia.			

SHEET 37

LOCATION	⑤			⑭			Case (see Sheet 76)	① A2-8			②④	Utilities*	Remarks	
	Width (LF)	Length (LF)	Area (SF)	Width (LF)	Length (LF)	Area (SF)		Length (LF)	6"-12" dia.	13"-24" dia.				25"+ dia.
10803 Townley Dr	-	-	-	-	-	-	-	1	-	-	-	-	-	-
10808 Townley Dr	-	-	-	12	11	132	3	-	-	-	-	-	-	-
10809 Townley Dr	-	-	-	14	5	70	3	-	-	-	-	-	-	-
10816 Townley Dr	-	-	-	12	5	60	3	-	-	-	-	-	-	-
10817 Townley Dr	-	-	-	13	5	65	3	-	-	-	-	-	-	-
10822 Townley Dr	-	-	-	18	5	90	3	-	-	-	-	-	-	-
10823 Townley Dr	-	-	-	18	5	90	3	-	-	-	-	-	-	-
10828 Townley Dr	-	-	-	15	5	75	3	-	-	-	-	-	-	-
10829 Townley Dr	-	-	-	13	5	65	3	-	-	-	-	-	-	-
10836 Townley Dr	-	-	-	14	5	70	3	-	-	-	-	-	-	-
10837 Townley Dr	-	-	-	15	5	75	3	-	-	-	-	-	-	-
10842 Townley Dr	-	-	-	17	5	85	3	-	-	-	-	-	-	-
10843 Townley Dr	-	-	-	15	5	75	3	-	-	-	-	-	-	-
10902 Townley Dr	-	-	-	15	5	75	3	-	-	-	-	-	-	-
10903 Townley Dr	-	-	-	15	5	75	3	-	-	-	-	-	-	-
10908 Townley Dr	-	-	-	16	5	80	3	-	-	-	-	-	-	-
10909 Townley Dr	-	-	-	16	5	80	3	-	-	-	-	-	-	-
10916 Townley Dr	-	-	-	15	5	75	3	-	-	-	-	-	-	-
10917 Townley Dr	-	-	-	16	5	80	3	-	-	-	-	-	-	-
10922 Townley Dr	-	-	-	16	5	80	3	-	-	-	-	-	-	-
10923 Townley Dr	-	-	-	15	5	75	3	-	-	-	-	-	-	-
10928 Townley Dr	-	-	-	15	5	75	3	-	-	-	-	-	-	-
10929 Townley Dr	-	-	-	15	5	75	3	-	-	-	-	-	-	-
10934 Townley Dr	-	-	-	17	5	85	3	-	-	-	-	-	-	-
10935 Townley Dr	-	-	-	16	5	80	3	-	-	-	-	-	-	-
Sheet total	0			1887			0	1	0	0	0			

SHEET 38

LOCATION	⑤			⑭			Case (see Sheet 76)	① A2-8			②④	Utilities*	Remarks	
	Width (LF)	Length (LF)	Area (SF)	Width (LF)	Length (LF)	Area (SF)		Length (LF)	6"-12" dia.	13"-24" dia.				25"+ dia.
11016 Townley Dr	-	-	-	13	8	104	3	-	-	1	-	-	-	-
11025 Townley Dr	-	-	-	15	8	120	3	40	-	1	-	-	-	-
11002 Townley Dr	-	-	-	13	5	65	3	-	-	-	-	-	-	-
11003 Townley Dr	-	-	-	14	5	70	3	-	-	-	-	-	-	-
11011 Townley Dr	-	-	-	14	8	112	3	-	-	-	-	-	-	-
Sheet total	0			471			40	0	2	0	0			

SHEET 39

LOCATION	⑤			⑭			Case (see Sheet 76)	① A2-8			②④	Utilities*	Remarks	
	Width (LF)	Length (LF)	Area (SF)	Width (LF)	Length (LF)	Area (SF)		Length (LF)	6"-12" dia.	13"-24" dia.				25"+ dia.
10827 Reichling Ln	5	100	500	20	5	100	3	25	-	-	-	-	-	on s/s of Reichling Ln e/o Norwalk Bl; commercial driveway
10909 Reichling Ln	4	16	64	17	5	85	1	20	-	-	-	-	-	-
10925 Reichling Ln	4	24	96	-	-	-	-	-	-	-	-	-	-	-
11003 Reichling Ln	4	16	64	-	-	-	-	-	-	-	-	-	-	-
11013 Reichling Ln	4	15	60	-	-	-	-	-	-	-	-	-	-	-
Sheet total	784			185			45	0	0	0	0			

SHEET 40

LOCATION	⑤			⑭			Case (see Sheet 76)	① A2-8			②④	Utilities*	Remarks	
	Width (LF)	Length (LF)	Area (SF)	Width (LF)	Length (LF)	Area (SF)		Length (LF)	6"-12" dia.	13"-24" dia.				25"+ dia.
11023 Reichling Ln	4	16	64	-	-	-	-	-	-	-	-	-	-	-
6824 Glangarry Av	5	52	260	-	-	-	-	-	-	-	-	-	-	on Reichling Ln
11115 Reichling Ln	5	50	250	-	-	-	-	40	-	1	-	-	-	-
11121 Reichling Ln	5	30	150	-	-	-	-	-	-	-	1	-	-	-
11127 Reichling Ln	5	30	150	-	-	-	-	-	-	-	1	-	-	-
11132 Reichling Ln	-	-	-	-	-	-	-	2	-	1	-	-	-	-
11155 Reichling Ln	-	-	-	-	-	-	-	13	-	-	-	-	-	-
Sheet total	874			0			55	0	2	0	2			

SHEET 41

LOCATION	⑤			⑭			Case (see Sheet 76)	① A2-8			②④	Utilities*	Remarks	
	Width (LF)	Length (LF)	Area (SF)	Width (LF)	Length (LF)	Area (SF)		Length (LF)	6"-12" dia.	13"-24" dia.				25"+ dia.
6875 Duchess Dr	4	15	60	22	7	154	1	-	-	-	-	-	-	AC driveway; on Reichling Ln
11202 Reichling Ln	-	-	-	24	7	168	3	24	-	1	-	-	-	-
6848 Vanport Av	4	50	200	-	-	-	-	-	-	1	-	-	-	on Reichling Ln
6915 Broadway	4	90	360	-	-	-	-	-	-	-	1	-	-	on Reichling Ln
Sheet total	620			322			24	0	2	0	1			


SHEET 42

LOCATION	⑤			⑭			Case (see Sheet 76)	① A2-8			②④	Utilities*	Remarks	
	Width (LF)	Length (LF)	Area (SF)	Width (LF)	Length (LF)	Area (SF)		Length (LF)	6"-12" dia.	13"-24" dia.				25"+ dia.
7018 Vicki Dr	-	-	-	20	4	80	3	-	-	-	-	-	-	-
7003 Vicki Dr	-	-	-	18	6	108	3	-	-	-	-	-	-	water meter ⁴
Sheet total	0			188			0	0	0	0	0			

* UTILITIES TO BE ADJUSTED BY OWNER
* SAN GABRIEL VALLEY WATER COMPANY

CADD PROJECT FILE NAME
\$FILES\$
CHECKER
B. FUNG
DESIGNER
J. GARCIA
DRAFTER
J. GARCIA

DATE	MARK	DESCRIPTION
10/25/2021		AS-BUILT
REVISIONS		

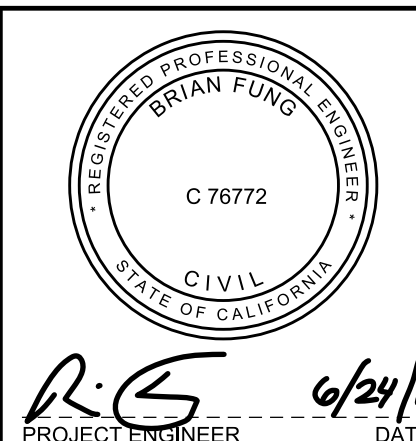

LOS ANGELES COUNTY PUBLIC WORKS
SOUTH WHITTIER LOS NIETOS
KEITH DRIVE, ET AL.
PROJECT ID NO. RMD4408001
PARKWAY IMPROVEMENTS TABLES

PD PH086592 SHEET 73 OF 79
PLAN RD