

### SHEET 43

LOCATION	⑤			⑭			Case (see Sheet 76)	① A2-8			④①			⑳②④	Utilities*	Remarks
	Width (LF)	Length (LF)	Area (SF)	Width (LF)	Length (LF)	Area (SF)		Length (LF)	6"-12" dia.	13"-24" dia.	25"+ dia.	Quantity				
Sheet total																

### SHEET 44

LOCATION	⑤			⑭			Case (see Sheet 76)	① A2-8			④①			⑳②④	Utilities*	Remarks
	Width (LF)	Length (LF)	Area (SF)	Width (LF)	Length (LF)	Area (SF)		Length (LF)	6"-12" dia.	13"-24" dia.	25"+ dia.	Quantity				
11154 Bradhurst St	4	14	56	16	7	112	3	-	-	-	-	-	-	-	-	AC driveway
Sheet total			56			112		0	0	0	0	0	0			

### SHEET 45

LOCATION	⑤			⑭			Case (see Sheet 76)	① A2-8			④①			⑳②④	Utilities*	Remarks
	Width (LF)	Length (LF)	Area (SF)	Width (LF)	Length (LF)	Area (SF)		Length (LF)	6"-12" dia.	13"-24" dia.	25"+ dia.	Quantity				
Sheet total																

### SHEET 46

LOCATION	⑤			⑭			Case (see Sheet 76)	① A2-8			④①			⑳②④	Utilities*	Remarks
	Width (LF)	Length (LF)	Area (SF)	Width (LF)	Length (LF)	Area (SF)		Length (LF)	6"-12" dia.	13"-24" dia.	25"+ dia.	Quantity				
11425 Loch Lomond Dr	-	-	-	-	-	-	-	40	-	-	-	-	-	-	-	-
11429 Loch Lomond Dr	-	-	-	-	-	-	-	13	-	-	-	-	-	-	-	-
11433 Loch Lomond Dr	-	-	-	-	-	-	-	30	-	-	-	-	-	-	-	-
11439 Loch Lomond Dr	-	-	-	-	-	-	-	30	-	-	-	-	-	-	-	-
11445 Loch Lomond Dr	-	-	-	-	-	-	-	30	-	-	-	-	-	-	-	-
11448 Loch Lomond Dr	-	-	-	-	-	-	-	30	-	-	-	-	-	-	-	-
11451 Loch Lomond Dr	-	-	-	-	-	-	-	20	-	-	-	-	-	-	-	-
11454 Loch Lomond Dr	4	14	56	16	5	80	1	40	-	-	-	-	-	1	-	AC driveway
11458 Loch Lomond Dr	-	-	-	-	-	-	-	27	-	-	-	-	-	-	-	-
11464 Loch Lomond Dr	-	-	-	-	-	-	-	36	-	-	-	-	-	-	-	-
11503 Loch Lomond Dr	4	42	168	-	-	-	-	40	-	-	-	-	-	-	-	-
11504 Loch Lomond Dr	-	-	-	-	-	-	-	40	-	-	-	-	-	-	-	-
11509 Loch Lomond Dr	-	-	-	-	-	-	-	40	-	-	-	-	-	-	-	-
11510 Loch Lomond Dr	-	-	-	-	-	-	-	-	-	-	-	-	-	-	-	-
11532 Loch Lomond Dr	4	14	56	16	5	80	1	33	-	-	-	-	-	-	-	AC driveway
11538 Loch Lomond Dr	4	14	56	16	5	80	1	40	-	-	-	-	-	-	-	AC driveway
Sheet total			336			240		489	0	0	0	0	13			

### SHEET 47

LOCATION	⑤			⑭			Case (see Sheet 76)	① A2-8			④①			⑳②④	Utilities*	Remarks
	Width (LF)	Length (LF)	Area (SF)	Width (LF)	Length (LF)	Area (SF)		Length (LF)	6"-12" dia.	13"-24" dia.	25"+ dia.	Quantity				
11548 Loch Lomond Dr	-	-	-	-	-	-	-	-	-	-	-	-	-	1	-	-
11559 Loch Lomond Dr	4	14	56	16	5	80	1	-	-	-	-	-	-	-	-	AC driveway
11565 Loch Lomond Dr	-	-	-	-	-	-	-	32	-	-	-	-	-	-	-	-
11566 Loch Lomond Dr	-	-	-	-	-	-	-	30	-	-	-	-	-	-	-	-
11570 Loch Lomond Dr	-	-	-	-	-	-	-	20	-	-	-	-	-	-	-	AC driveway
11571 Loch Lomond Dr	4	14	56	16	5	80	1	15	-	-	-	-	-	-	-	AC driveway
Sheet total			112			160		97	0	0	0	0	3			

### SHEET 48

LOCATION	⑤			⑭			Case (see Sheet 76)	① A2-8			④①			⑳②④	Utilities*	Remarks
	Width (LF)	Length (LF)	Area (SF)	Width (LF)	Length (LF)	Area (SF)		Length (LF)	6"-12" dia.	13"-24" dia.	25"+ dia.	Quantity				
11436 Havenwood Dr	-	-	-	-	-	-	-	30	-	-	-	-	-	1	-	-
11441 Havenwood Dr	4	14	56	16	7	112	1	47	-	-	-	-	-	-	-	AC driveway
11452 Havenwood Dr	4	14	56	16	7	112	1	-	-	-	-	-	-	-	-	AC driveway
11453 Havenwood Dr	-	-	-	-	-	-	-	15	-	-	-	-	-	1	-	-
11474 Havenwood Dr	4	14	56	20	7	140	1	-	-	-	-	-	-	-	-	AC driveway
11502 Havenwood Dr	4	14	56	16	7	112	1	-	-	-	-	-	-	1	-	AC driveway
11503 Havenwood Dr	4	14	56	16	7	112	1	-	-	-	-	-	-	1	-	AC driveway
Sheet total			280			588		92	0	0	0	0	4			

### SHEET 49

LOCATION	⑤			⑭			Case (see Sheet 76)	① A2-8			④①			⑳②④	Utilities*	Remarks
	Width (LF)	Length (LF)	Area (SF)	Width (LF)	Length (LF)	Area (SF)		Length (LF)	6"-12" dia.	13"-24" dia.	25"+ dia.	Quantity				
11531 Havenwood Dr	4	14	56	16	7	112	1	-	-	-	-	-	-	1	-	-
11534 Havenwood Dr	-	-	-	-	-	-	-	-	-	-	-	-	-	1	-	-
11535 Havenwood Dr	4	14	56	16	7	112	1	-	-	-	-	-	-	1	-	-
11541 Havenwood Dr	-	-	-	-	-	-	-	-	-	-	-	-	-	1	-	-
11546 Havenwood Dr	-	-	-	-	-	-	-	25	-	-	-	-	-	1	-	-
11547 Havenwood Dr	4	14	56	16	7	112	1	-	-	-	-	-	-	-	-	AC driveway
11553 Havenwood Dr	4	14	56	16	7	112	1	24	-	-	-	-	-	1	-	-
11556 Havenwood Dr	-	-	-	-	-	-	-	27	-	-	-	-	-	-	-	-
11557 Havenwood Dr	4	14	56	16	7	112	1	-	-	-	-	-	-	1	-	AC driveway
11563 Havenwood Dr	-	-	-	-	-	-	-	23	-	-	-	-	-	1	-	-
Sheet total			280			560		99	0	0	0	0	8			

### SHEET 50


LOCATION	⑤			⑭			Case (see Sheet 76)	① A2-8			④①			⑳②④	Utilities*	Remarks
	Width (LF)	Length (LF)	Area (SF)	Width (LF)	Length (LF)	Area (SF)		Length (LF)	6"-12" dia.	13"-24" dia.	25"+ dia.	Quantity				
11431 Bexley Dr	-	-	-	-	-	-	-	35	-	-	-	-	-	1	-	-
Sheet total			0			0		35	0	0	0	0	1			

### SHEET 51

LOCATION	⑤			⑭			Case (see Sheet 76)	① A2-8			④①			⑳②④	Utilities*	Remarks
	Width (LF)	Length (LF)	Area (SF)	Width (LF)	Length (LF)	Area (SF)		Length (LF)	6"-12" dia.	13"-24" dia.	25"+ dia.	Quantity				
11509 Bexley Dr	-	-	-	-	-	-	-	30	-	-	-	-	-	-	-	-
11513 Bexley Dr	-	-	-	16	11	176	2	30	-	-	-	-	-	-	-	AC driveway
11531 Bexley Dr	-	-	-	-	-	-	-	40	-	-	-	-	-	1	-	-
11535 Bexley Dr	-	-	-	-	-	-	-	40	-	-	-	-	-	1	-	-
11541 Bexley Dr	-	-	-	16	11	176	2	56	-	-	-	-	-	1	-	AC driveway
7105 Gretna Av	-	-	-	-	-	-	-	40	-	-	-	-	-	4	-	On Bexley Dr
7105 Gretna Av	-	-	-	-	-	-	-	50	-	-	-	-	-	-	-	On Bexley Dr
Sheet total			0			352		286	0	0	0	0	7			

\* UTILITIES TO BE ADJUSTED BY OWNER

10/25/2021	AS-BUILT
DATE	MARK
REVISIONS	

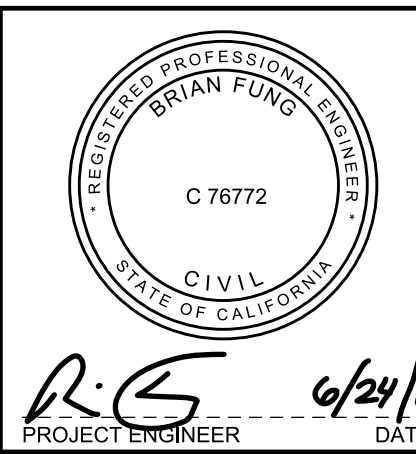

LOS ANGELES COUNTY PUBLIC WORKS

## SOUTH WHITTIER LOS NIETOS

KEITH DRIVE, ET AL.

PROJECT ID NO. RMD4408001  
PARKWAY IMPROVEMENTS TABLES

PROJECT ENGINEER: *R.S.* DATE: 6/24/19

PD PH086593 SHEET 74 OF 79

CAD PROJECT FILE NAME: \$FILES\$  
 CHECKER: B. FUNG  
 DESIGNER: J. GARCIA  
 DRAFTER: J. GARCIA