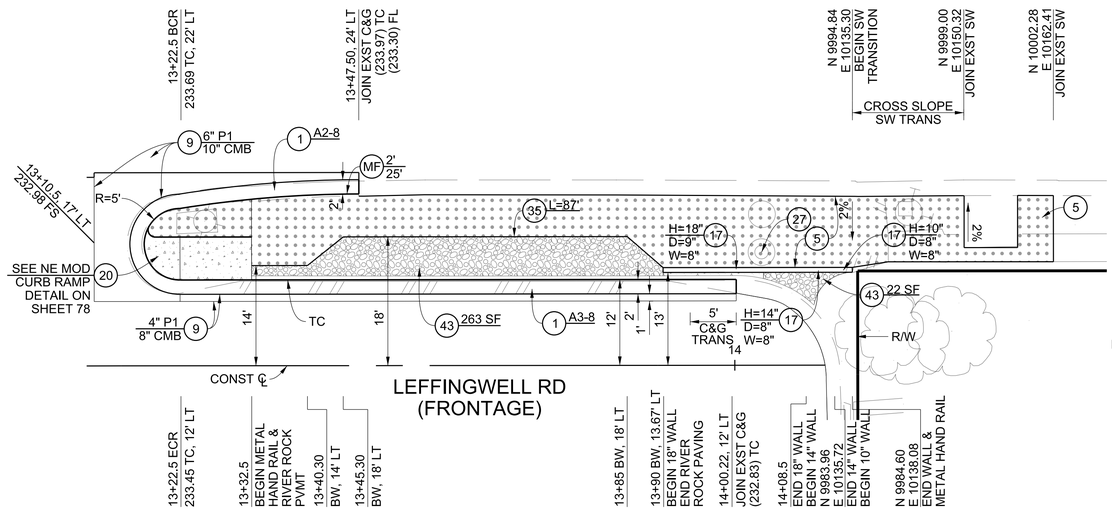

NORTHEAST MEDIAN DETAIL
SCALE 1"=10'

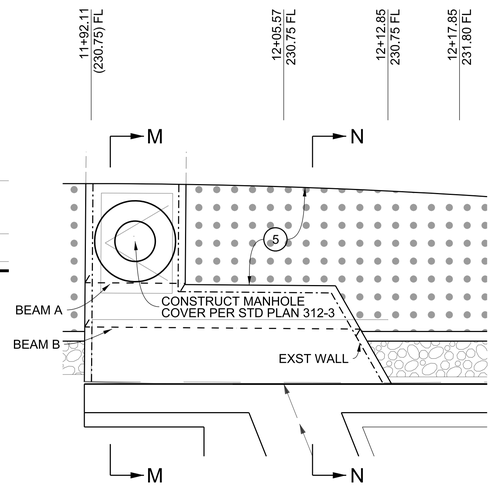

INLET DETAIL
SCALE 1"=5'

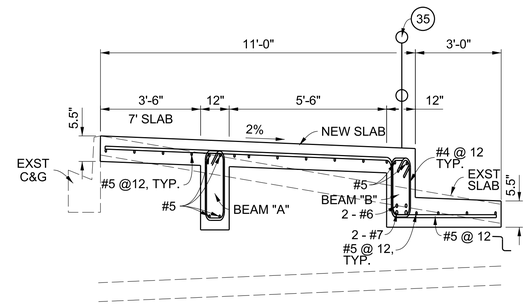

SECTION M-M
NO SCALE

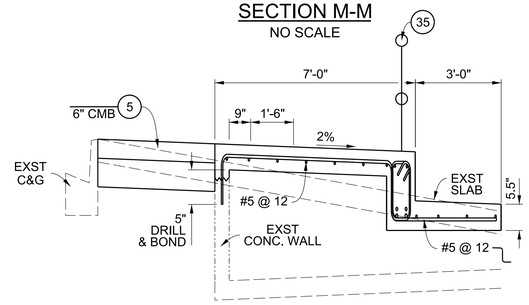

NOTE: FOR DETAILS NOT SHOWN, SEE SECTION M-M.

SECTION N-N
NO SCALE

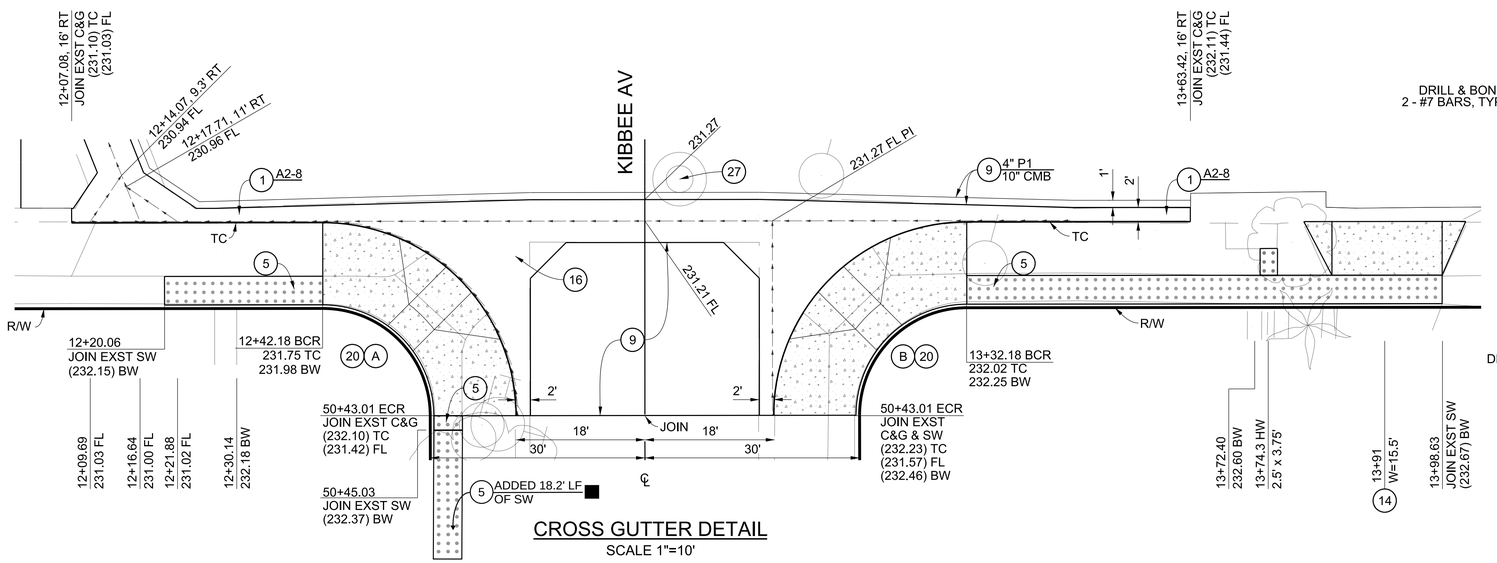

CROSS GUTTER DETAIL
SCALE 1"=10'

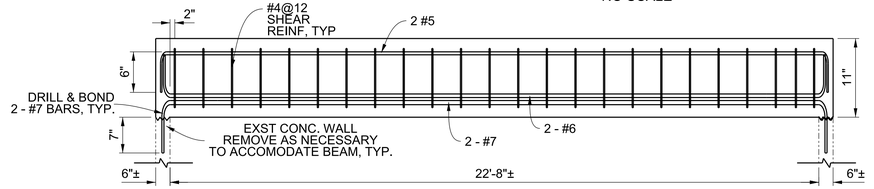

SECTION AT BEAM "B"
NO SCALE

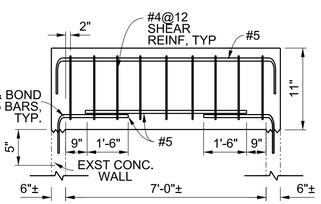

SECTION AT BEAM "A"
NO SCALE

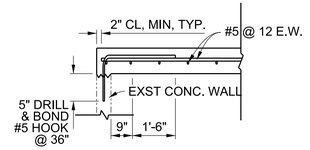

SLAB CONNECTION TO EXST WALL
NO SCALE

SEE RIVER ROCK PAVING DETAIL ON SHEET 77

CURVE DATA

CURVE	RADIUS	CENTRAL ANGLE	LENGTH	TANGENT
A	27'	90°01'27"	42.42'	27.01'
B	27'	89°58'33"	42.40'	26.99'

DATE	MARK	DESCRIPTION
10/25/2021	■	AS-BUILT

REVISIONS

REGISTERED PROFESSIONAL ENGINEER
JAVANEH NOORPARVAR
C 86389
CIVIL
STATE OF CALIFORNIA

PROJECT ENGINEER — 7/15/2019 DATE

LOS ANGELES COUNTY PUBLIC WORKS

SOUTH WHITTIER LOS NIETOS
KEITH DRIVE, ET AL.

PROJECT ID NO. RMD4408001
TYPICAL SECTIONS AND DETAILS

PD PH086598 | SHEET 79 OF 79

DESIGNER J. NOORPARVAR
CHECKER J. MELGAR
DRAFTER B. SUBEH
CADD PROJECT FILE NAME RMD4408001-PLAN-RD.DGN

PLAN RD

DATE: $DATE$ TIME: $TIME$ FILE: RMD4408001-PLAN-RD.DGN